



| POINT NAME | Y          | X           | LAT        | LONG      |
|------------|------------|-------------|------------|-----------|
| START      | 121479.578 | 293050.338  | -26.479998 | 27.781694 |
| END        | 118751.400 | 2930915.327 | -26.483161 | 27.809019 |

| NAME  | Y        | X         |
|-------|----------|-----------|
| 51467 | 12749.58 | 293600.41 |
| 8-1   | 12745.59 | 293608.76 |
| 8-2   | 12745.59 | 293608.76 |
| 8-3   | 12747.70 | 293603.61 |
| 8-4   | 12745.90 | 293600.61 |
| 8-5   | 12749.11 | 293608.68 |
| 8-6   | 12745.06 | 293604.89 |
| 8-7   | 12745.06 | 293604.89 |
| 8-96  | 12745.06 | 293604    |

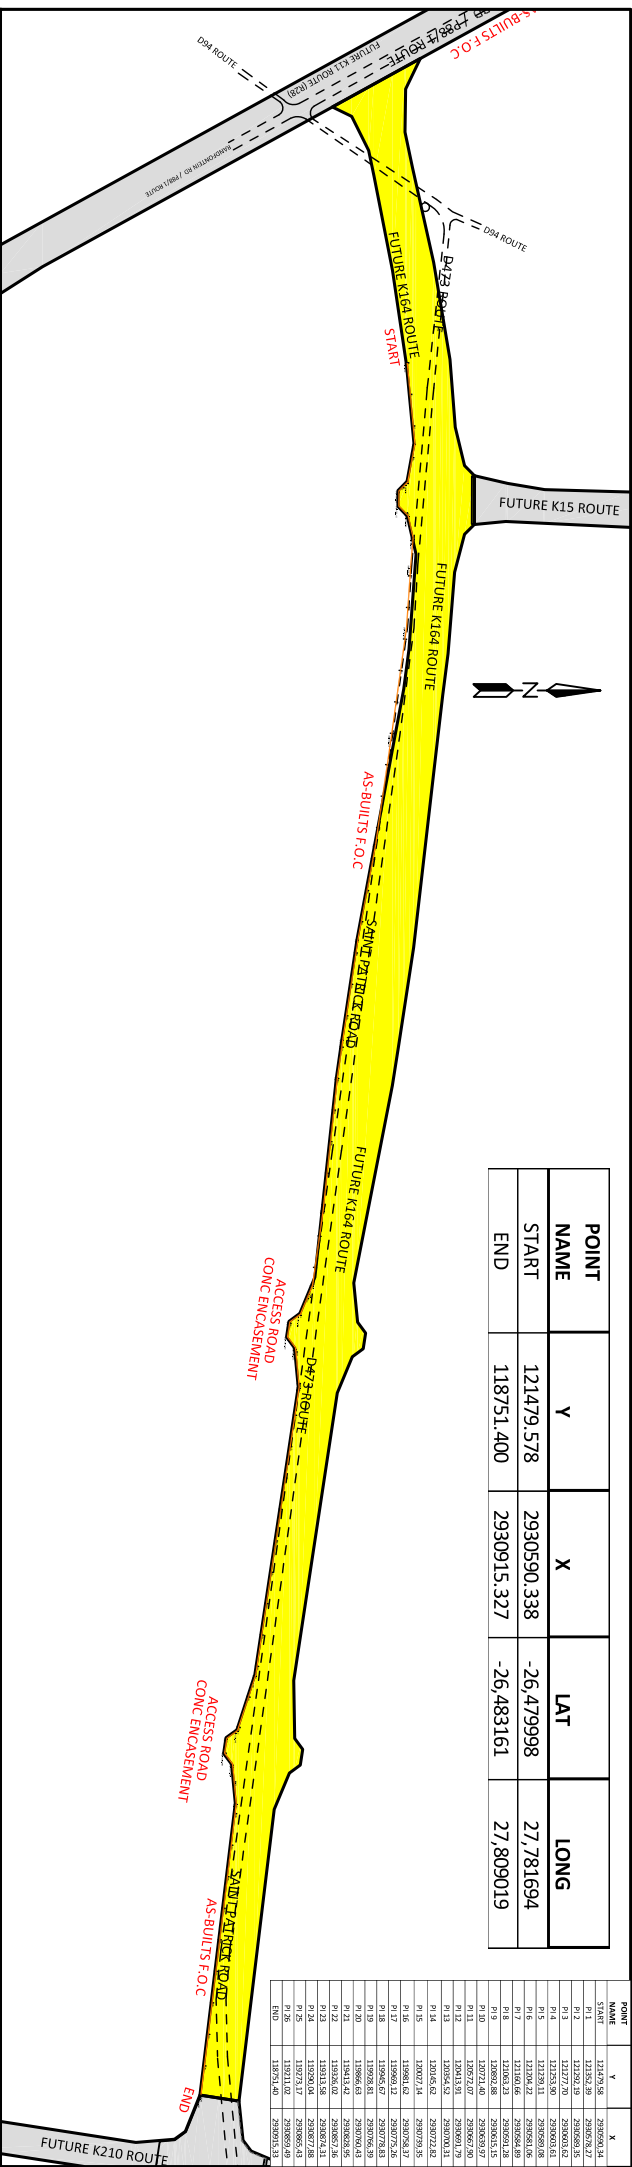

GAUTRANS SERVITUDE FUTURE K164 ROUTE (D473 ROUTE) SAINT PATRICK ROAD

## AS-BUILTS OVER HEAD F.O.C

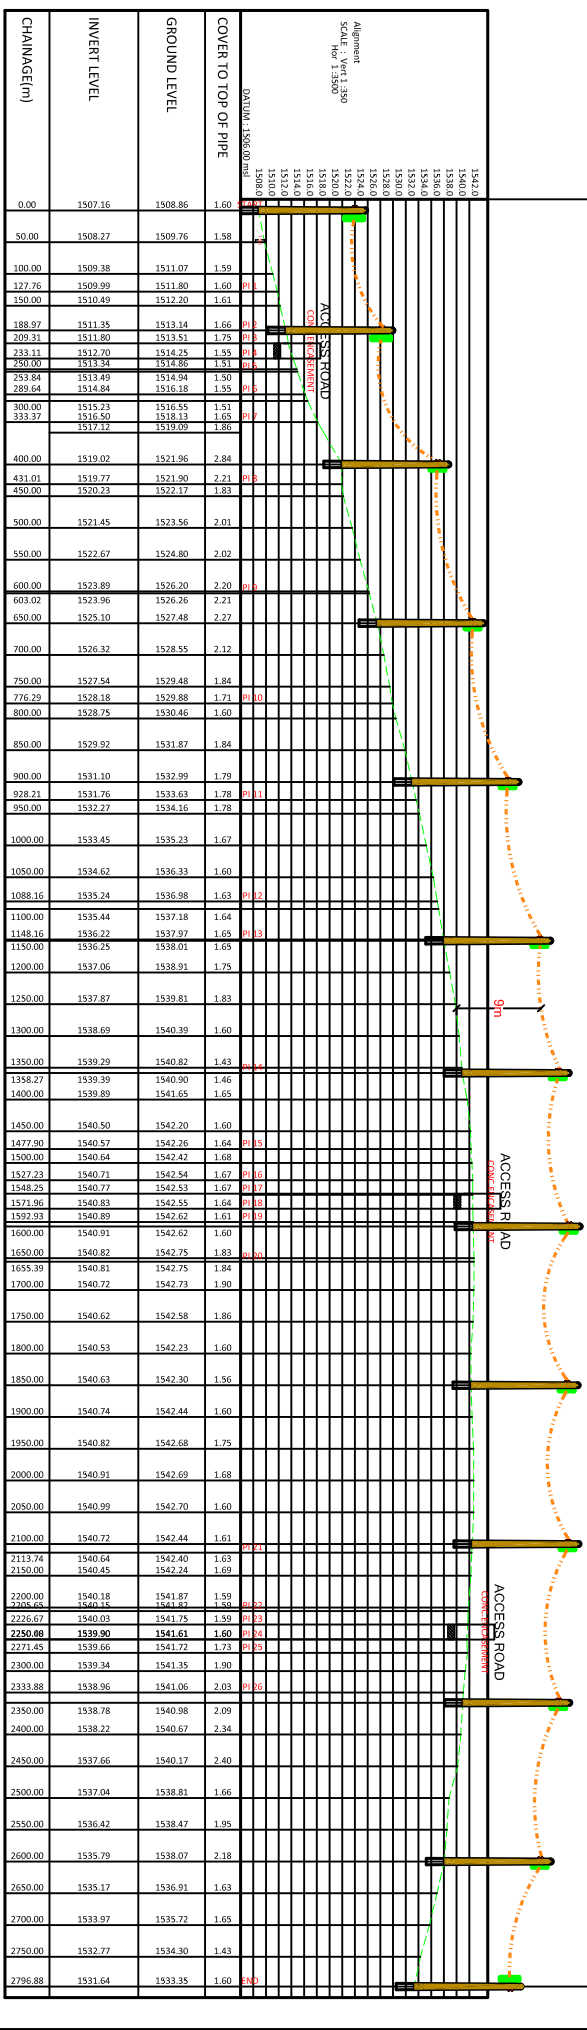

LEGEND:

AS-BUILTS FIBRE CABLE

Wayleave REF Number  
12/1/20/3/K164/FOC/0122  
Approval Number  
2V-2025/536

[illegible]

12354 Kall Street  
Winchester Hill  
Johannesburg  
1863

Company Reg No. 2019/380204/07  
Tax Reg No. 9709565178  
Contact: 069 208 3492



JELANI WAYLEAVE and PLANNING  
PO BOX 257  
RUMSIG  
011 764 2518 / 079 896 3390  
ajprowals@jelaninwayleaves.co.za

Huesat Techno-High South Africa (PTY) Ltd  
 11 1st Floor Huesat Office Park, 124 Veldman Service Rd  
 Woodmead, Sandton  
 2191  
 Mr. Brian Ndlovu (065 915 3172) or Faridat (074 038  
 8216)

**AS-BUILT'S**  
OPTIC FIBRE CABLE  
PARALLEL SECTION PLAN  
OVER  
**FUTURE K164 ROUTE (DU73 ROUTE)**  
SAIT PATICK ROAD  
POORU JIE CHU TO CH2/76.68mm  
DATE 2003  
DRAWN